


Measured Marks:

- Start: at 50 Broad St (North side road) 29'-8" South of light pole #8 & Blue Cross Arena (South side of road) 24'-5" North of light pole #9A
- 1 Mile: at 33 Madison St 26'-4" South of storm drain on West side of road
- 2 Mile: at 343 State St (Eastman Kodak) 18' South of light pole #40
- 3 Mile: on Court St at Blue Cross Arena loading docks, 10'-2" East of storm drain
- Finish: on Exchange Blvd at Blue Cross Arena main entrance at light pole #10

Elevations:

- Start = 520 feet
- Finish = 505 feet
- Highest = 525 feet
- Lowest = 500 feet

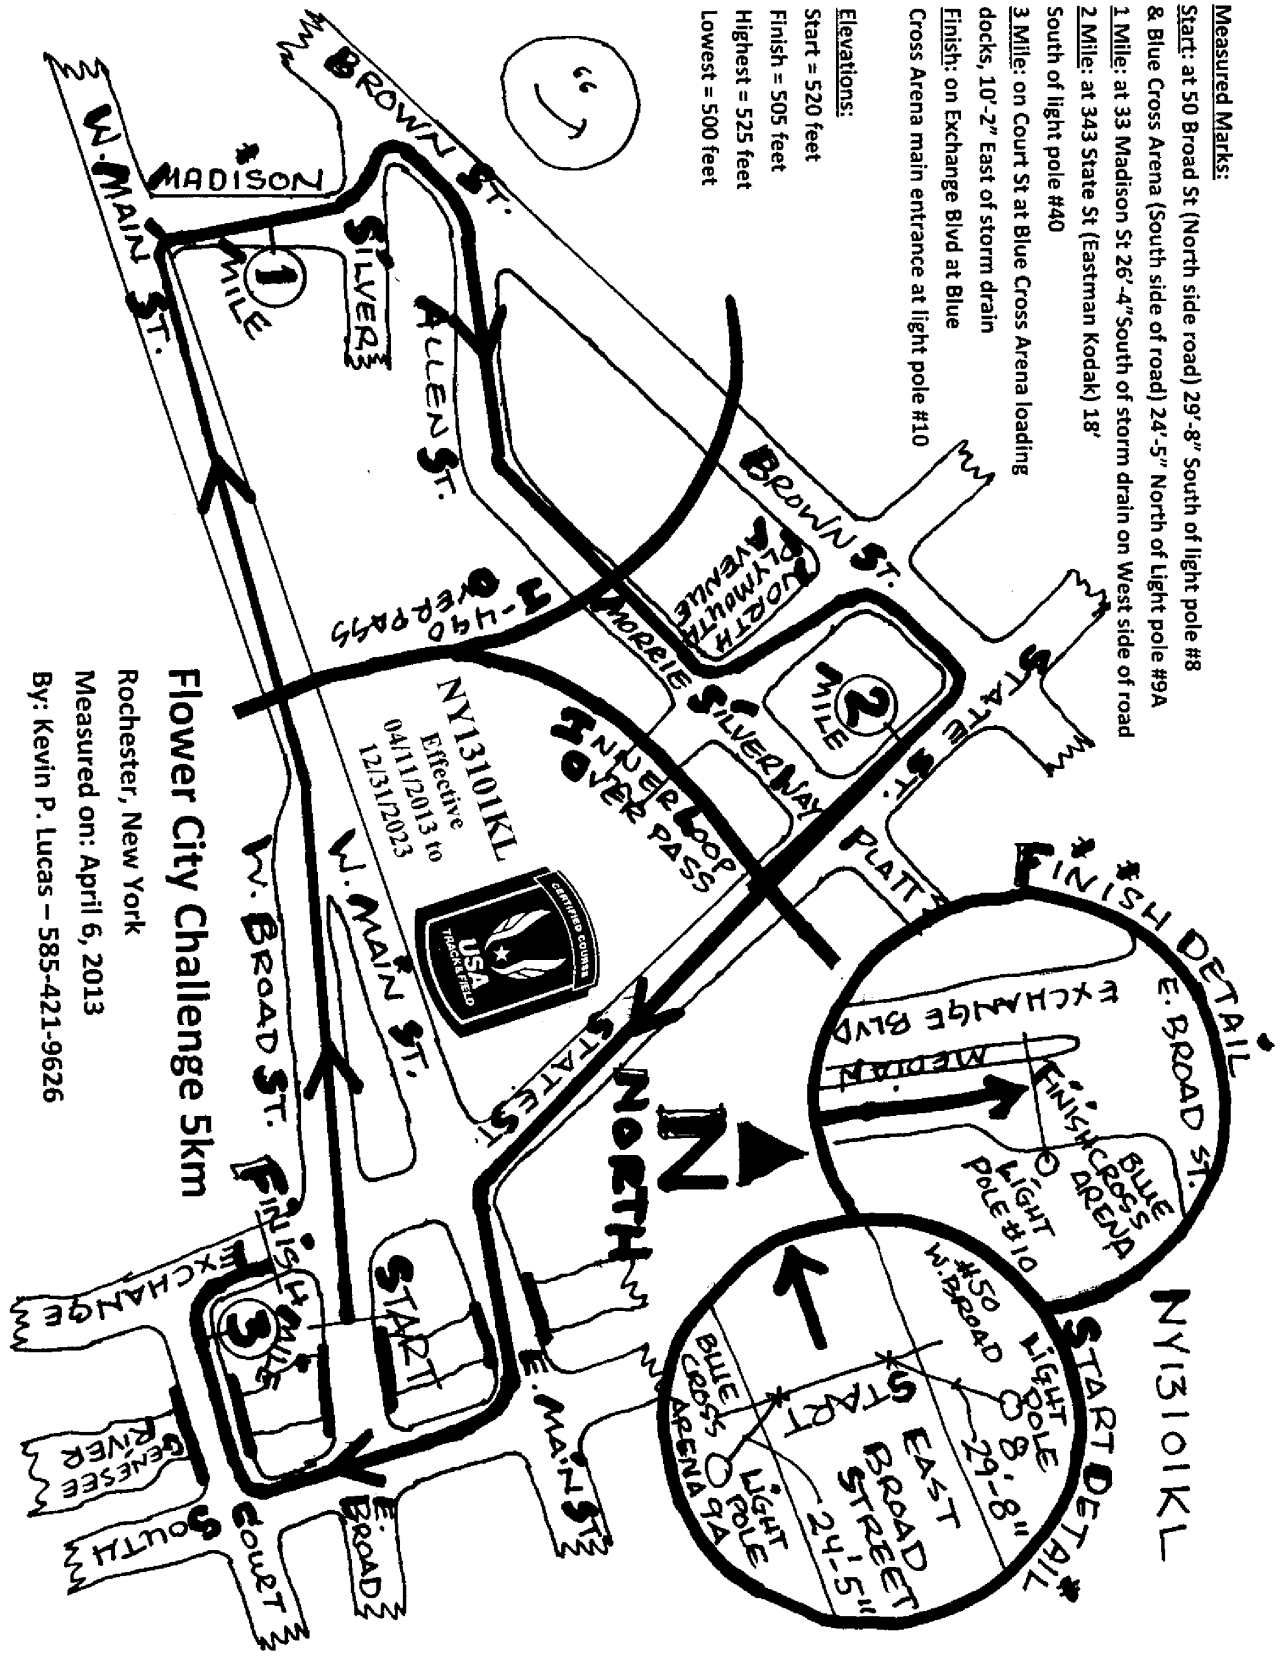

Flower City Challenge 5km

Rochester, New York
 Measured on: April 6, 2013
 By: Kevin P. Lucas - 585-421-9626

NY13101KL



**Road Running Technical Council
USA Track & Field
Measurement Certificate**



Name of the course Flower City Challenge 5 km Distance 5 km
 Location (state) New York (city) Rochester
 Type of course: road race calibration track Configuration: loop
 Type of surface: paved 100 % dirt _____ % gravel _____ % grass _____ % track _____ %
 Elevation (meters above sea level) Start 158 Finish 154 Highest 160 Lowest 152
 Straight line distance between start & finish 96 meters Drop 0.80 m/km Separation 1.92 %
 Measured by (name, address, phone & e-mail) Kevin P. Lucas, 94 South Ridge Trail, Fairport, NY 14450-3843, 585-421-9626, & k p lucas@frontiernet.net
 Race contact (name, address, phone & e-mail) Dave "Boots" Boutillier, c/o Fleet Feet Sports -YellowJacket Racing, 2210 Monroe Avenue, Rochester, NY 14618, 585-697-3338
 Measuring Methods: bicycle steel tape electronic distance meter
 Number of measurements of entire course: 2 Date(s) when course measured: April 6, 2013
 Race date: April 28, 2013 Course certification effective date: April 11, 2013
 Certification code: NY13101KL

Notice to Race Director: Use this Certification Code in *all* public announcements relating to your race.

Be It Officially Noted That

Based on examination of data provided by the above named measurer, the course described above and in the map attached is hereby certified as reasonably accurate in measurement according to the standards adopted by the Road Running Technical Council. If *any* changes are made to the course, this certification becomes void, and the course must then be recertified.

Verification of Course — In the event a National Open Record is set on this course, or at the discretion of USA Track & Field, a verification remeasurement may be required to be performed by a member of the Road Running Technical Council. If such a remeasurement shows the course to be short, then all pending records will be rejected and the course certification will be cancelled.

This certification expires on December 31 in the year

2023

AS NATIONALLY CERTIFIED BY:

Date: April 11, 2013

Kevin P. Lucas – USATF/RRTC National Certifier
 94 South Ridge Trail, Fairport, NY 14450-3843, 585-421-9626, & k_p_lucas@frontiernet.net