



Pumpkins in the Park 5 km Cobbs Hill Park, Rochester, New York

Measured on: May 25, 2019 By: Kevin P. Lucas - lucasmmeasurement@gmail.com

Measured Marks & Elevations:

Start @ 500 feet elevation: on Norris Drive at Lake Riley Lodge, 59 feet 6" East of pow
22 feet 3" West of Park Speed Limit 20 sign, both on North side of road

1 Mile @ 540 feet elevation: at #22 Nunda Blvd on Cobbs Hill Drive, 17 feet 2" North of storm drain on East side of road

2 Mile @ 635 feet elevation: on Reservoir Road at NE corner, 47 feet 8" South of concrete pillar on West side of road

3 Mile @ 506 feet elevation: at #63 Culver Road, 36 feet 11" South of light pole #6 on East side of road



Turn from Culver Road to Grass @ 506 feet elevation: 15 feet South of light pole #6 on East side of road

Finish @ 500 feet elevation: on grass at baseball right outfield, 14 feet East of manhole cover & 15 feet East of manhole cover on grass, both are East of Culver Road & South of Norris Drive

NY19106KL

Effective

05/27/2019 to
12/31/2029

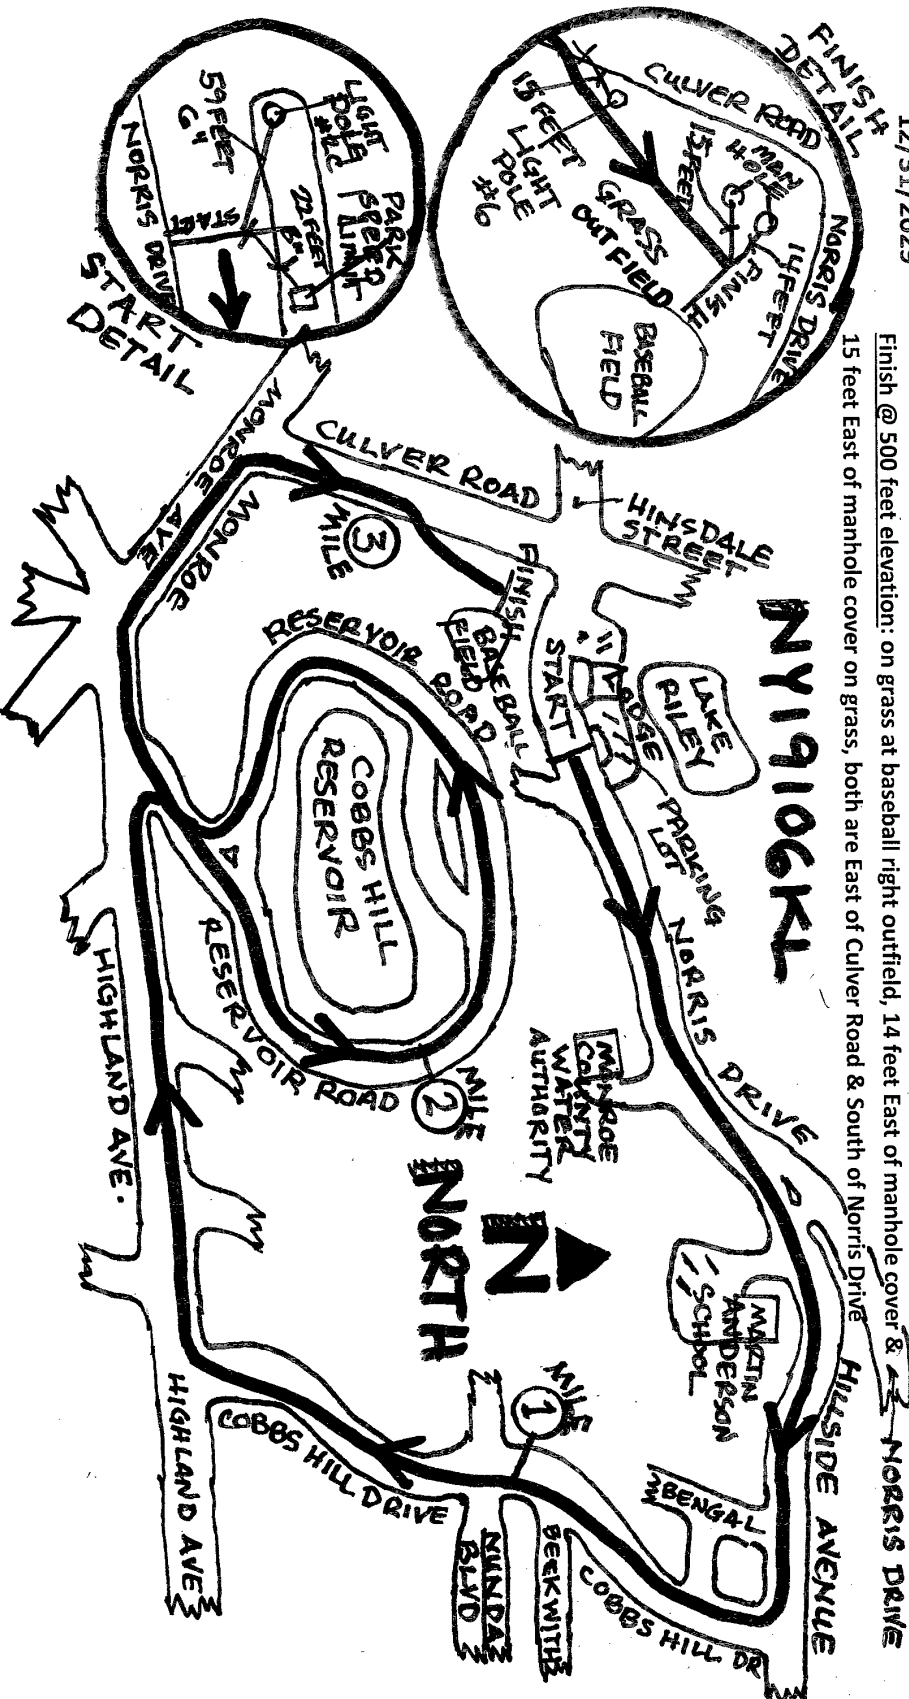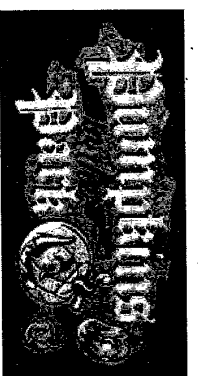



**Road Running Technical Council
USA Track & Field**

Measurement Certificate

recognized by



Name of the course Pumpkins in the Park 5 km Distance 5 km
Location (state) New York (city) Rochester
Type of course: road race ☒ calibration course ☐
Measuring method: bicycle ☒ steel tape ☐ electronic distance meter ☐
Measured by (name, address, phone & e-mail) Kevin P. Lucas, 94 South Ridge Trail, Fairport, NY
14450-3843, 585-421-9626 & lucasmeasurement@gmail.com
Race contact (name, address, phone & e-mail) Boots, c/o YellowJacket Racing,
155 Culver Road, Suite 110, Rochester, NY 14620-2678, 585-732-1090
Date(s) when course measured: May 25, 2019
Number of measurements of entire course: 2 Course Configuration: loop
Elevation (meters above sea level) Start 152.4 Finish 152.4 Highest 195.1 Lowest 150.1
Straight line distance between start & finish 160 meters Drop 0.0 m/km Separation 3.2 %
Type of surface: paved >98 % dirt % gravel % grass <3 % track %
Effective date of certification: May 27, 2019 Certification code: NY19106KL

Notice to Race Director: Use this Certification Code
in *all* public announcements relating to your race.

Be It Officially Noted That

Based on examination of data provided by the above named measurer, the course described above and in the map attached is hereby certified as reasonably accurate in measurement according to the standards adopted by the Road Running Technical Council. If *any* changes are made to the course, this certification becomes void, and the course must then be recertified.

Verification of Course — In the event a National Open Record is set on this course, or at the discretion of USA Track & Field, a verification remeasurement may be required to be performed by a member of the Road Running Technical Council. If such a remeasurement shows the course to be short, then all pending records will be rejected and the course certification will be cancelled.

This certification expires on December 31 in the year

2029

AS NATIONALLY CERTIFIED BY:

Date: May 27, 2019

Kevin P. Lucas - USATF/RRTC Certifier

94 South Ridge Trail, Fairport, NY 14450-3843, 585-421-9626 & lucasmeasurement@gmail.com