



**Road Running Technical Council  
USA Track & Field  
Measurement Certificate**



Name of the course Caryville Inn Turkey Trot 5 km Distance 5 km  
Location (state) NY (city) Oakfield  
Type of course: Road Race  
Measuring Methods: Bicycle  
Measured By Kevin Lucas - 94 South Ridge Trail - Fairport, NY 14450 - (585) 899-9749 - lucasmeasurement@gmail.com  
Race Contact Erin Farnham - Caryville Inn, 25 Main Street, Oakfield, NY 14125 - 585-356-4091  
Date(s) when course measured: 09/16/2023  
Number of measurements of entire course: 2 Course Configuration: partial loop  
Elevation (meters above sea level) Start 229.00 Finish 227.00 Lowest 223 Highest 236  
Straight line distance between start and finish 41 m Drop 0.40 m/km Separation 0.82 %  
Type of surface: Paved 100 % Dirt 0 % Gravel 0 % Grass 0 % Track 0 %  
Effective date of certification: September 20, 2023 Certification code: NY23011KL

Note to Race Director: Use this Certification Code  
in all public announcements relating to your race.

## ***Be It Officially Noted That***

Based on examination of data provided by the above named measurer, the course described above and in the map attached is hereby certified as reasonably accurate in measurement according to the standards adopted by the Road Running Technical Council. If any changes are made to the course, this certification becomes void, and the course must then be recertified.

**Verification of Course ---** In the event a National Open Record is set on the course, or at the discretion of USA Track & Field, a verification measurement may be required to be performed by a member of the Road Running Technical Council. If such a remeasurement shows the course to be short, then all pending records will be rejected and the course certification will be cancelled.

***This certification expires on December 31 of the year:*** **2033**

**AS NATIONALLY CERTIFIED BY:**

Date: September 21, 2023

Kevin Lucas - USATF/RRTC Certifier - 94 South Ridge Trail, Fairport NY 14450  
(585) 899-9749 - lucasmeasurement@gmail.com

## Caryville Inn Turkey Trot 5km, Oakfield, New York

Measured on: September 16, 2023

By: Kevin P. Lucas, WA-'B' Measurer, [lucasmmeasurement@gmail.com](mailto:lucasmmeasurement@gmail.com) & 585-899-9749 with Steve Fitch

"This course was measured using the full width of the road and the Shortest Possible Route (SPR)"

### Measured Marks & Elevations:


Start @ 750ft: at Caryville Inn 25 Main St., at power pole #138 on South side of road

1 Mile @ 748ft: at 1 Farnsworth Ave. (just East of N. Main St.), 12ft-9" East of power pole #16 on West side of road

2 Mile @ 741ft: at 25 Coe Ave. (just West of Didge St.), 27ft-6" East of center of driveway on North side of road

3 Mile @ 752ft: on N. Pearl St. (just North of S. Main St.), 36ft-4" North of fire hydrant on West side of road

Finish @ 745ft: at 21 Main St. (just East of Water St.) at crosswalk, 6ft-10" West of storm drain on North side of road

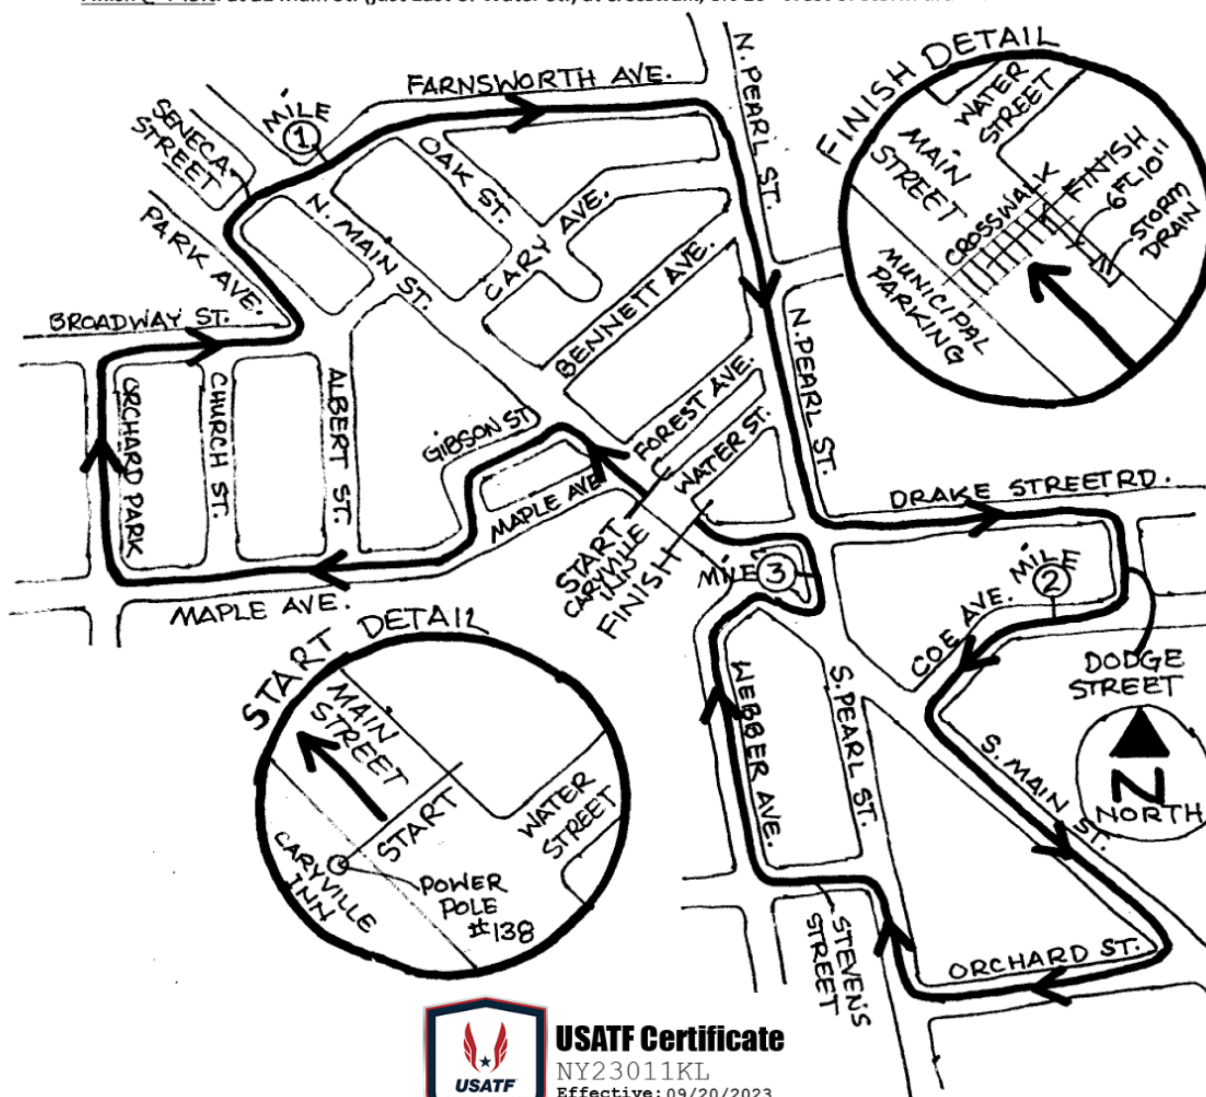

**USATF Certificate**

NY23011KL

Effective: 09/20/2023

Through: 12/31/2033